




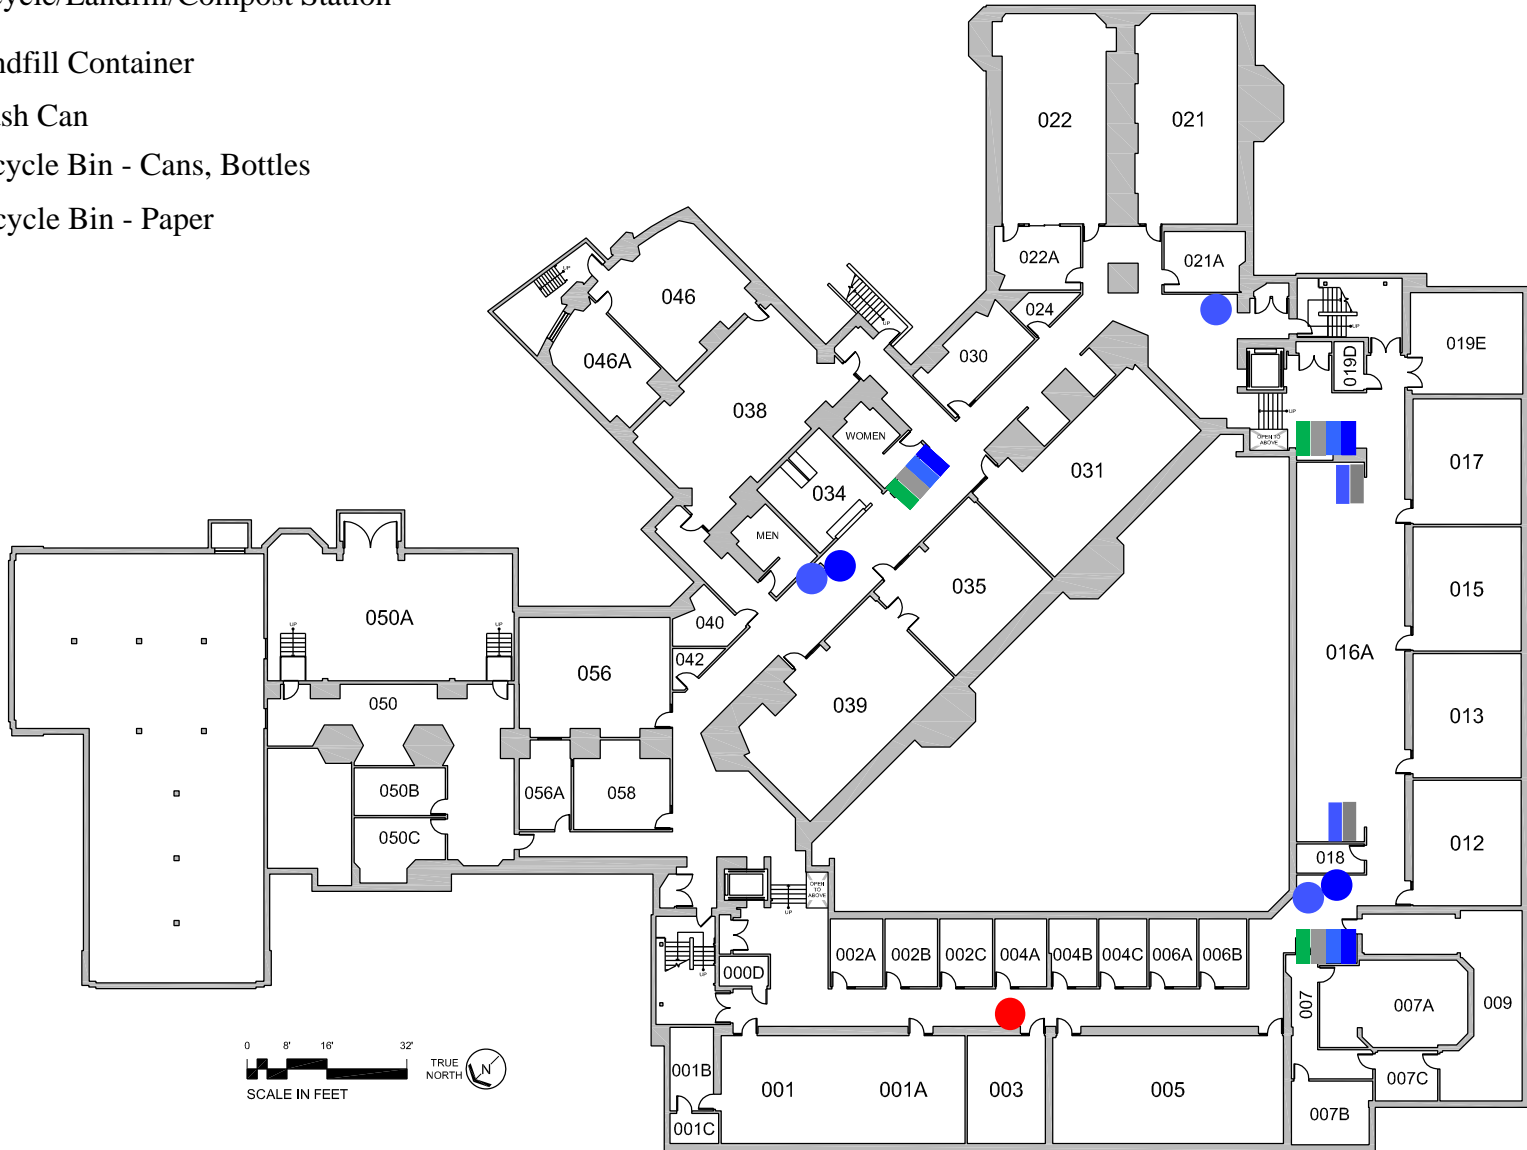





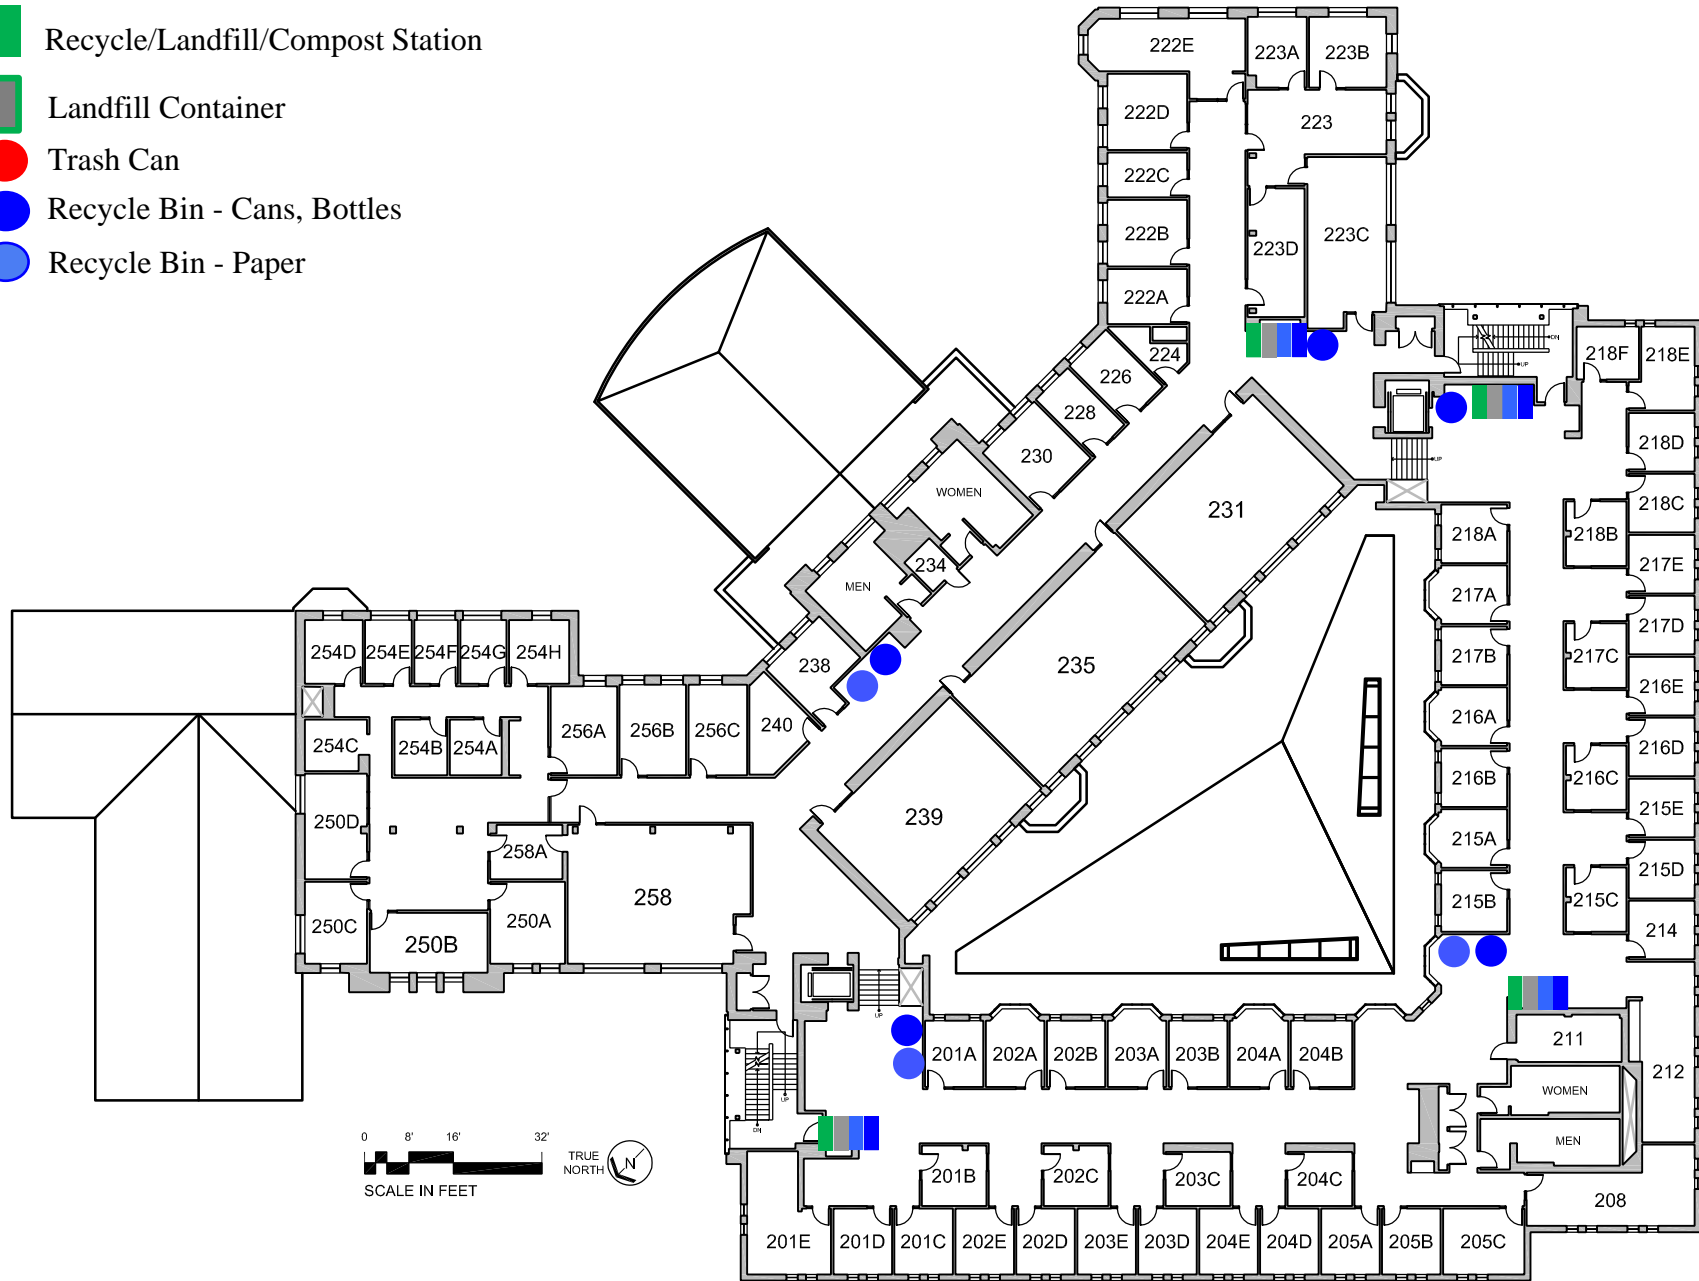


-  Recycle/Landfill/Compost Station
-  Landfill Container
-  Trash Can
-  Recycle Bin - Cans, Bottles
-  Recycle Bin - Paper








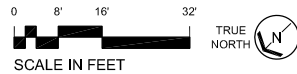
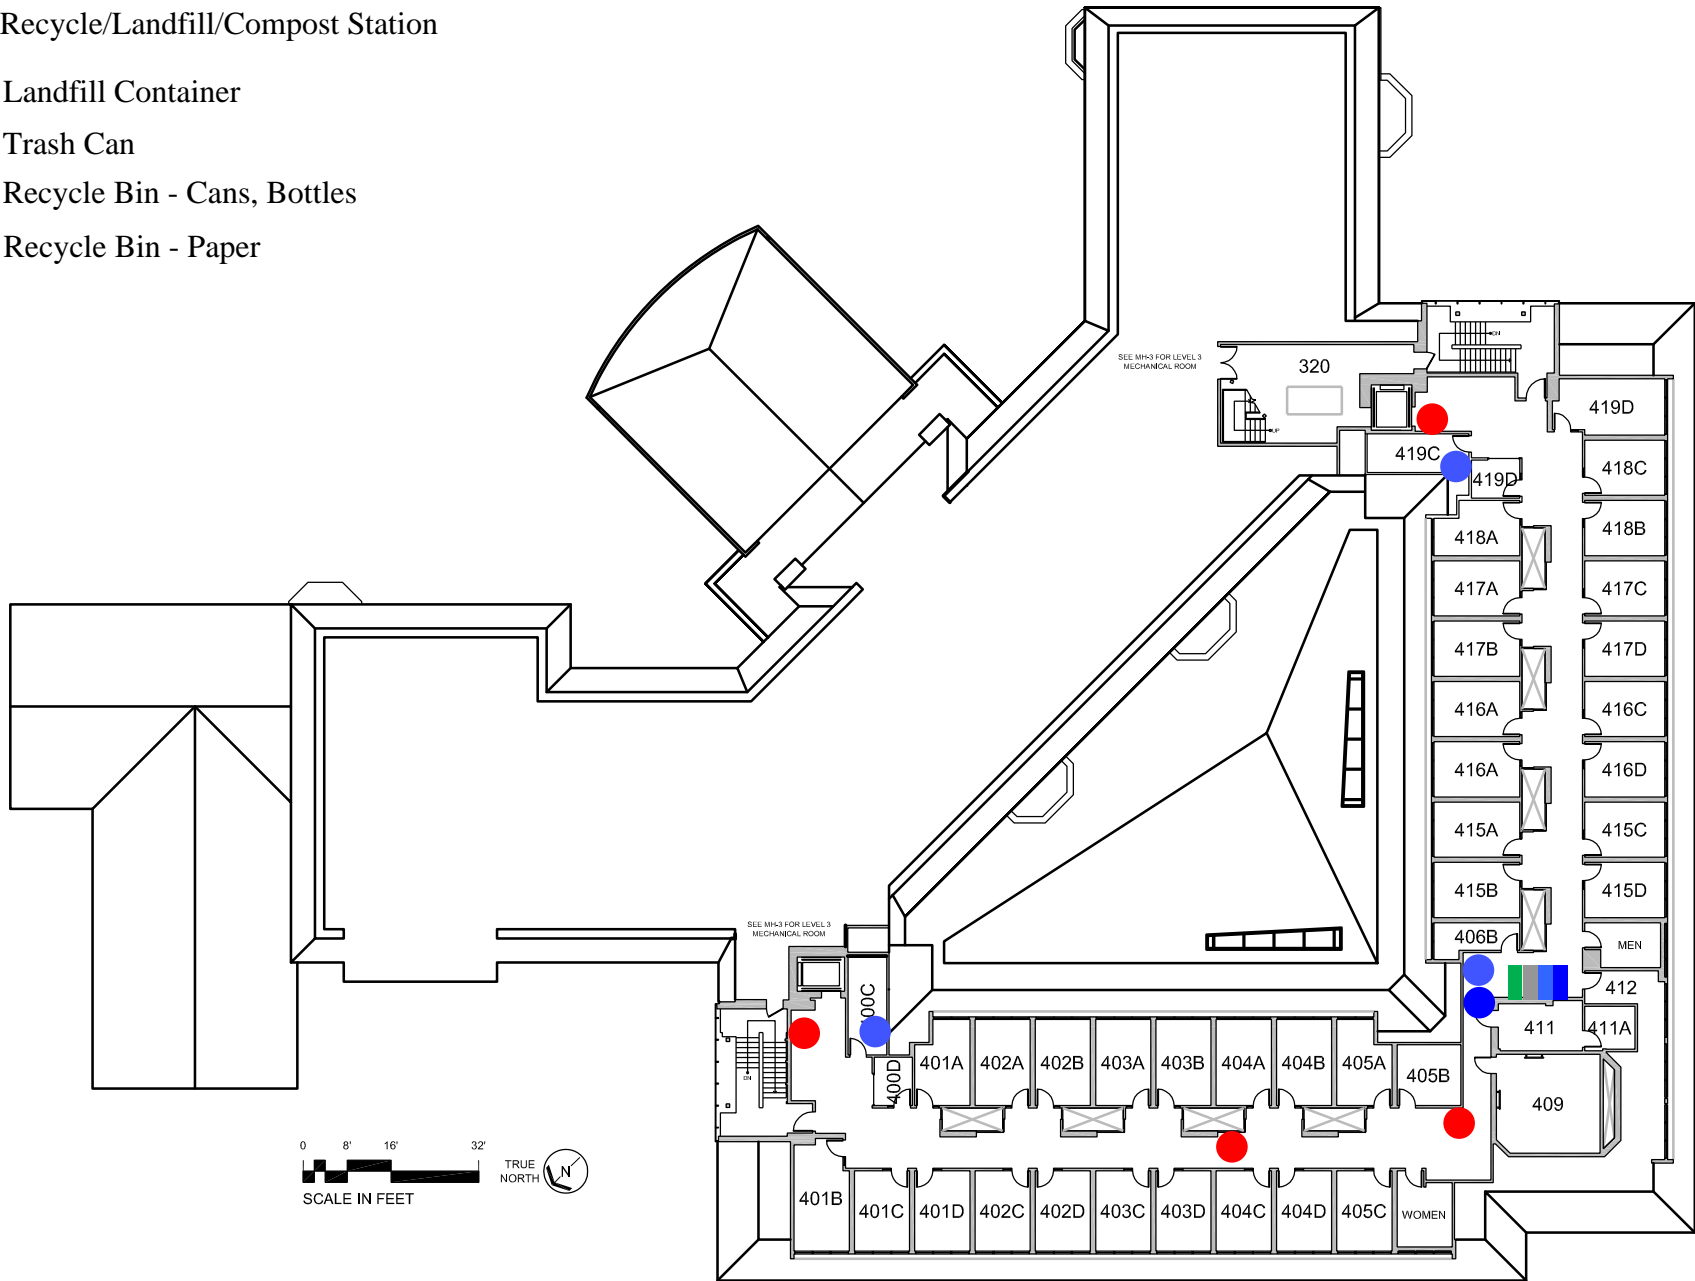
| REV | DATE | DESCRIPTION | BY |
|-----|--------|-------------|-----|
| 1 | 9/2011 | ASBUILT | JDH |
| | | | |
| | | | |

-  Recycle/Landfill/Compost Station
-  Landfill Container
-  Trash Can
-  Recycle Bin - Cans, Bottles
-  Recycle Bin - Paper



| REV | DATE | DESCRIPTION | BY |
|-----|--------|-------------|-----|
| 1 | 9/2011 | ASBUILT | JDH |
| | | | |
| | | | |

-  Recycle/Landfill/Compost Station
-  Landfill Container
-  Trash Can
-  Recycle Bin - Cans, Bottles
-  Recycle Bin - Paper



Building
MH
 Floor #
4

MILLER HALL
 FLOOR FOUR



| REV | DATE | DESCRIPTION | BY |
|-----|--------|-------------|-----|
| 1 | 9/2011 | ASBUILT | JDH |
| | | | |
| | | | |

Building/Zone
MH
 Floor #
4